




REV	DATE	DRAWN	CHECKED	RELEASE LEVEL
1	03/05/15	TL	BM	PERMIT SET
2	04/17/15	TL	BM	CONSTRUCTION SET
3	11/24/15	LD	SL	RECORD DRAWINGS
4	10/15/18	JR	LLQ	UPDATED FOR BES ADDITION

SCALES STATED ON DRAWINGS ARE VALID ONLY WHEN PLOTTED ARCH D 24" X 36"

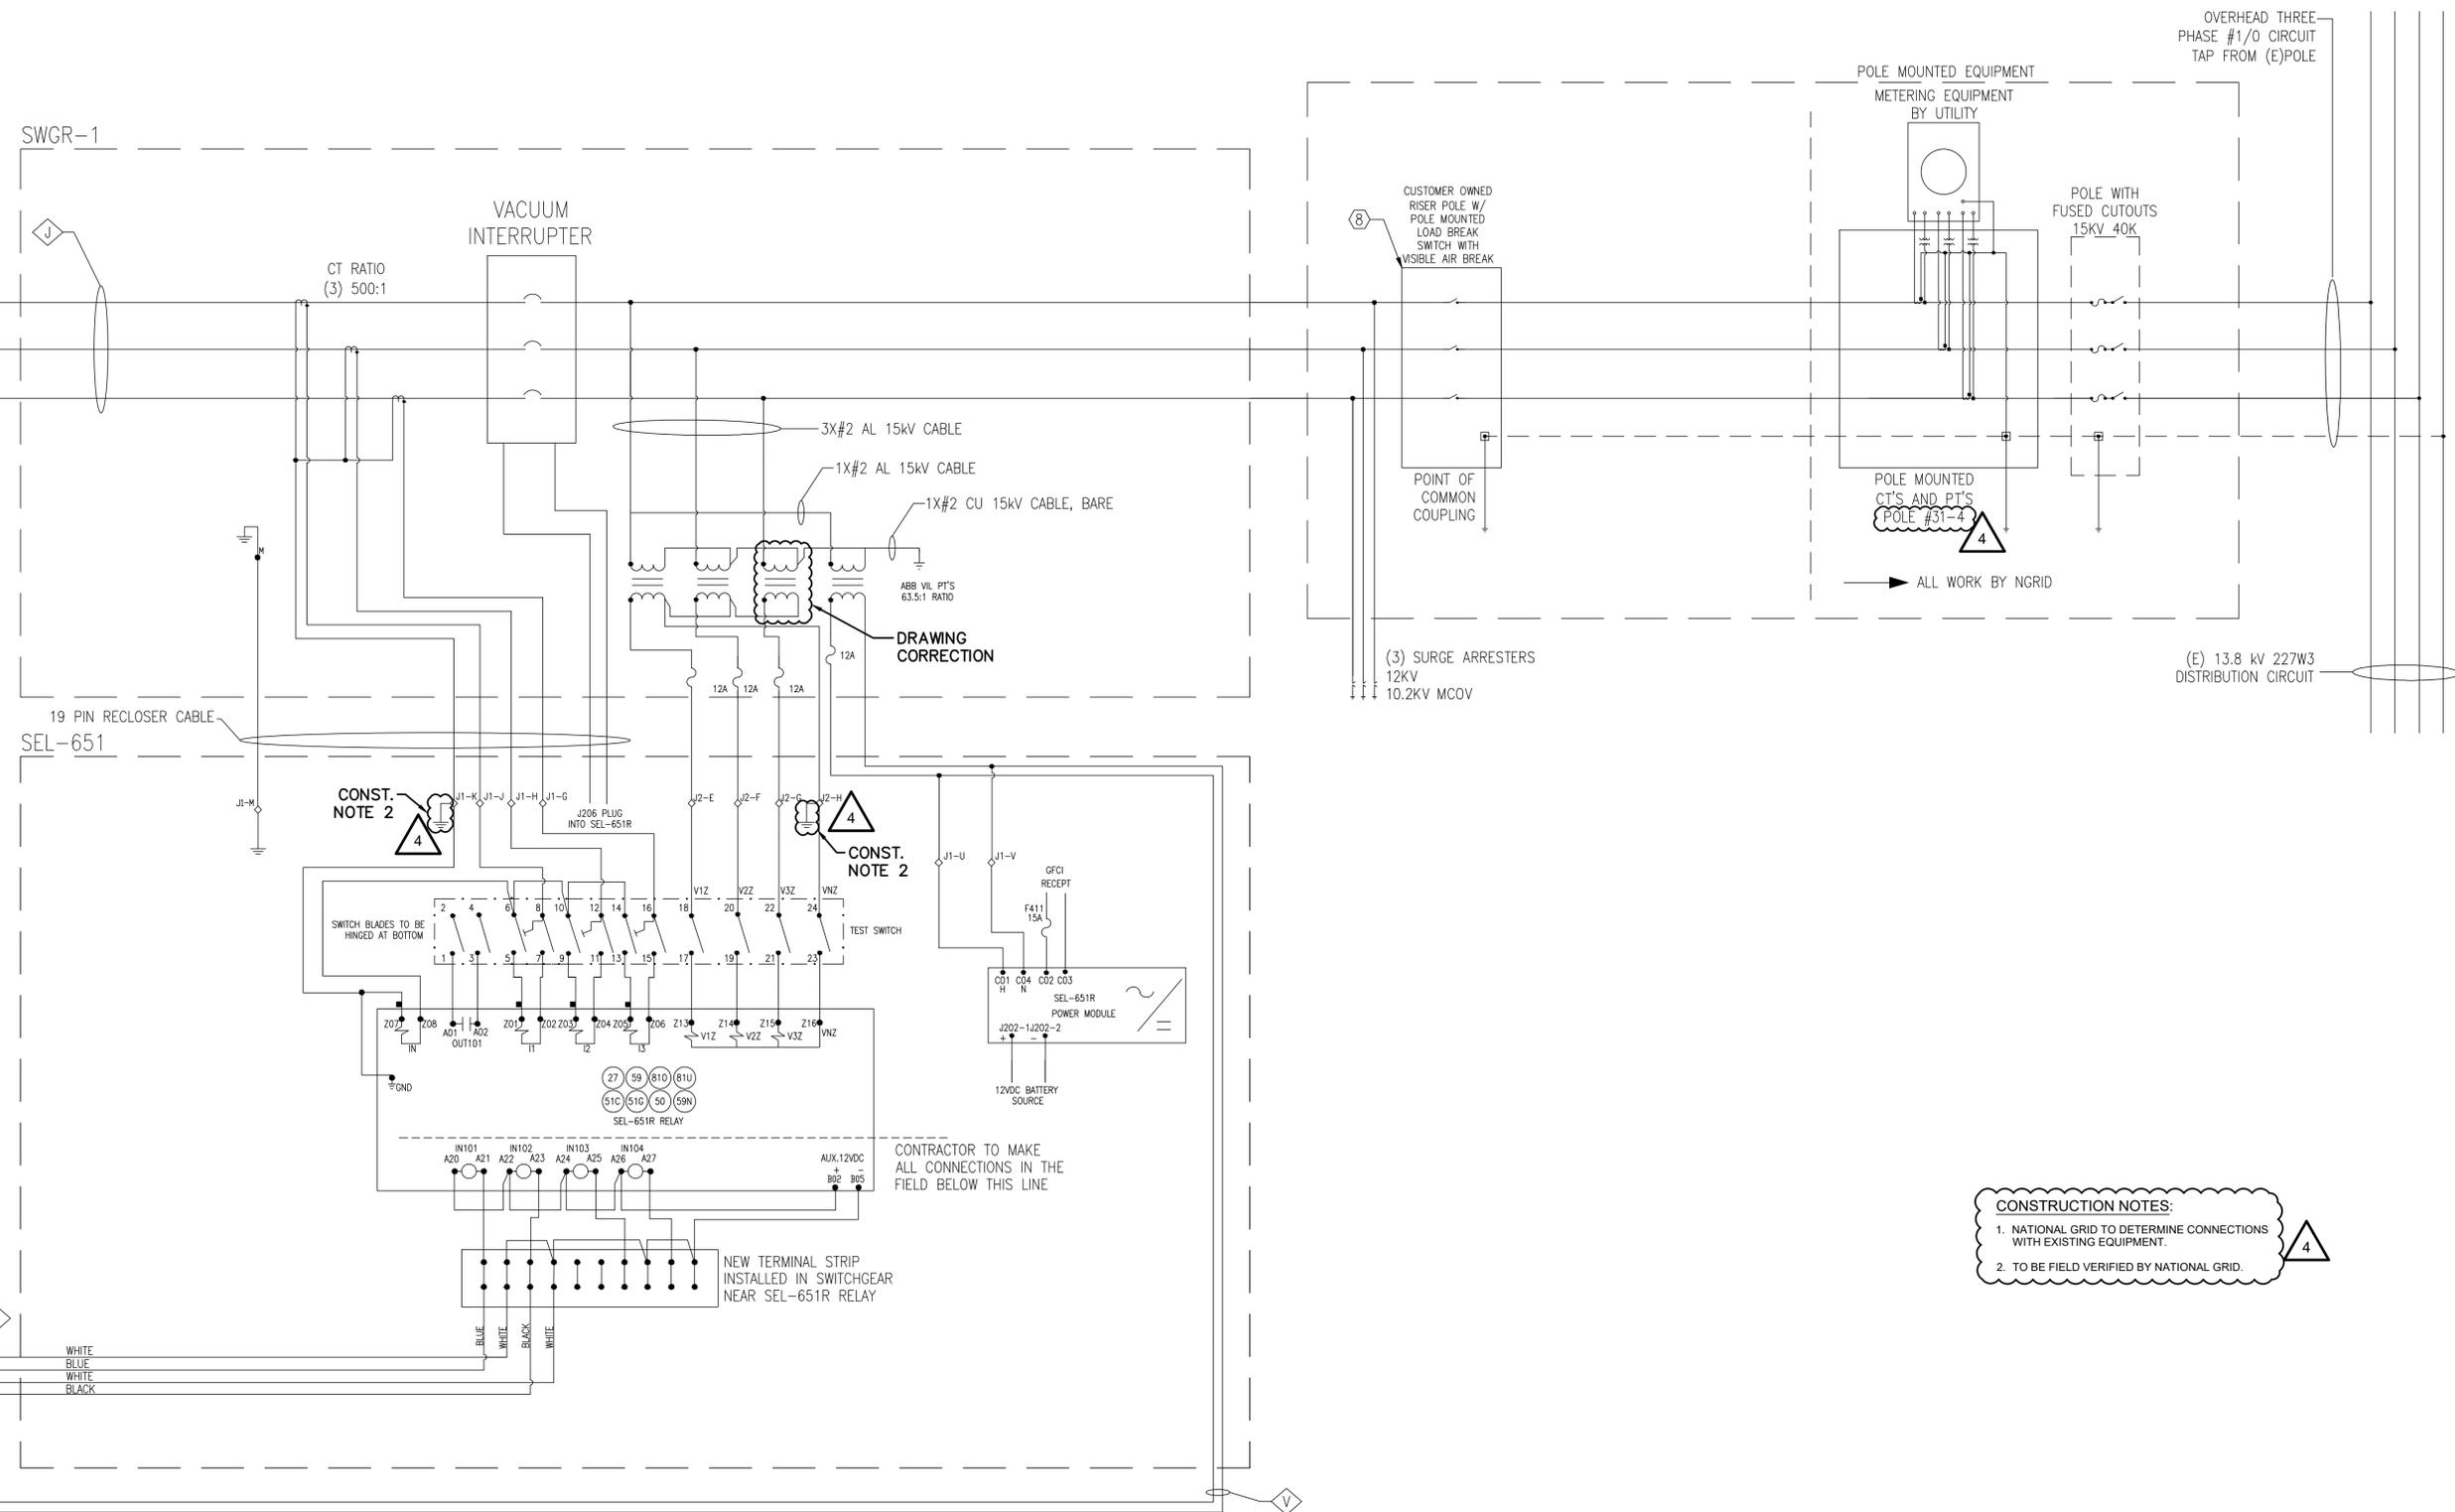

TO CONNECTION 1  
SEE DWG.  
MAN17077-D-3101

TO CONNECTION X  
SEE DWG. E-2.4

TO CONNECTION Y  
SEE DWG. E-2.4

CONST. NOTE 2

CONST. NOTE 2

CONSTRUCTION NOTES:  
1. NATIONAL GRID TO DETERMINE CONNECTIONS WITH EXISTING EQUIPMENT.  
2. TO BE FIELD VERIFIED BY NATIONAL GRID.

DRAWING UPDATED FOR CONNECTION TO BES ADDITION. EPS E&D, TAKES EXCEPTION TO THE CERTIFICATION OF THE EXISTING ACCURACY OF THE DRAWINGS OR INSTALLED EQUIPMENT.

**ISSUED FOR CONSTRUCTION**  
**OCT 15, 2018**

