



**BORREGO SOLAR**

1115 WESTFORD STREET, 2ND FLOOR  
LONDONDERRY, NH 03051  
PHONE: (888) 898-6273  
FAX: (888) 843-6778  
WWW.BORREGOSOLAR.COM


NATIONAL GRID  
GROTON RD-SHIRLEY  
SHIRLEY, MA 01464

PROJECT NUMBER:  
905-0522

REV	DATE	BY	CHKD	RELEASE LEVEL
1	03/05/15	TL	BM	PERMIT SET
2	04/17/15	TL	BM	CONSTRUCTION SET
3	11/24/15	LD	SL	RECORD DRAWINGS
4	10/15/18	JR	LLQ	UPDATED FOR BES ADDITION

SCALES STATED ON DRAWINGS ARE VALID ONLY WHEN PLOTTED ARCH D 24" x 36"

**E-2.4**  
AC THREE LINE DIAGRAM

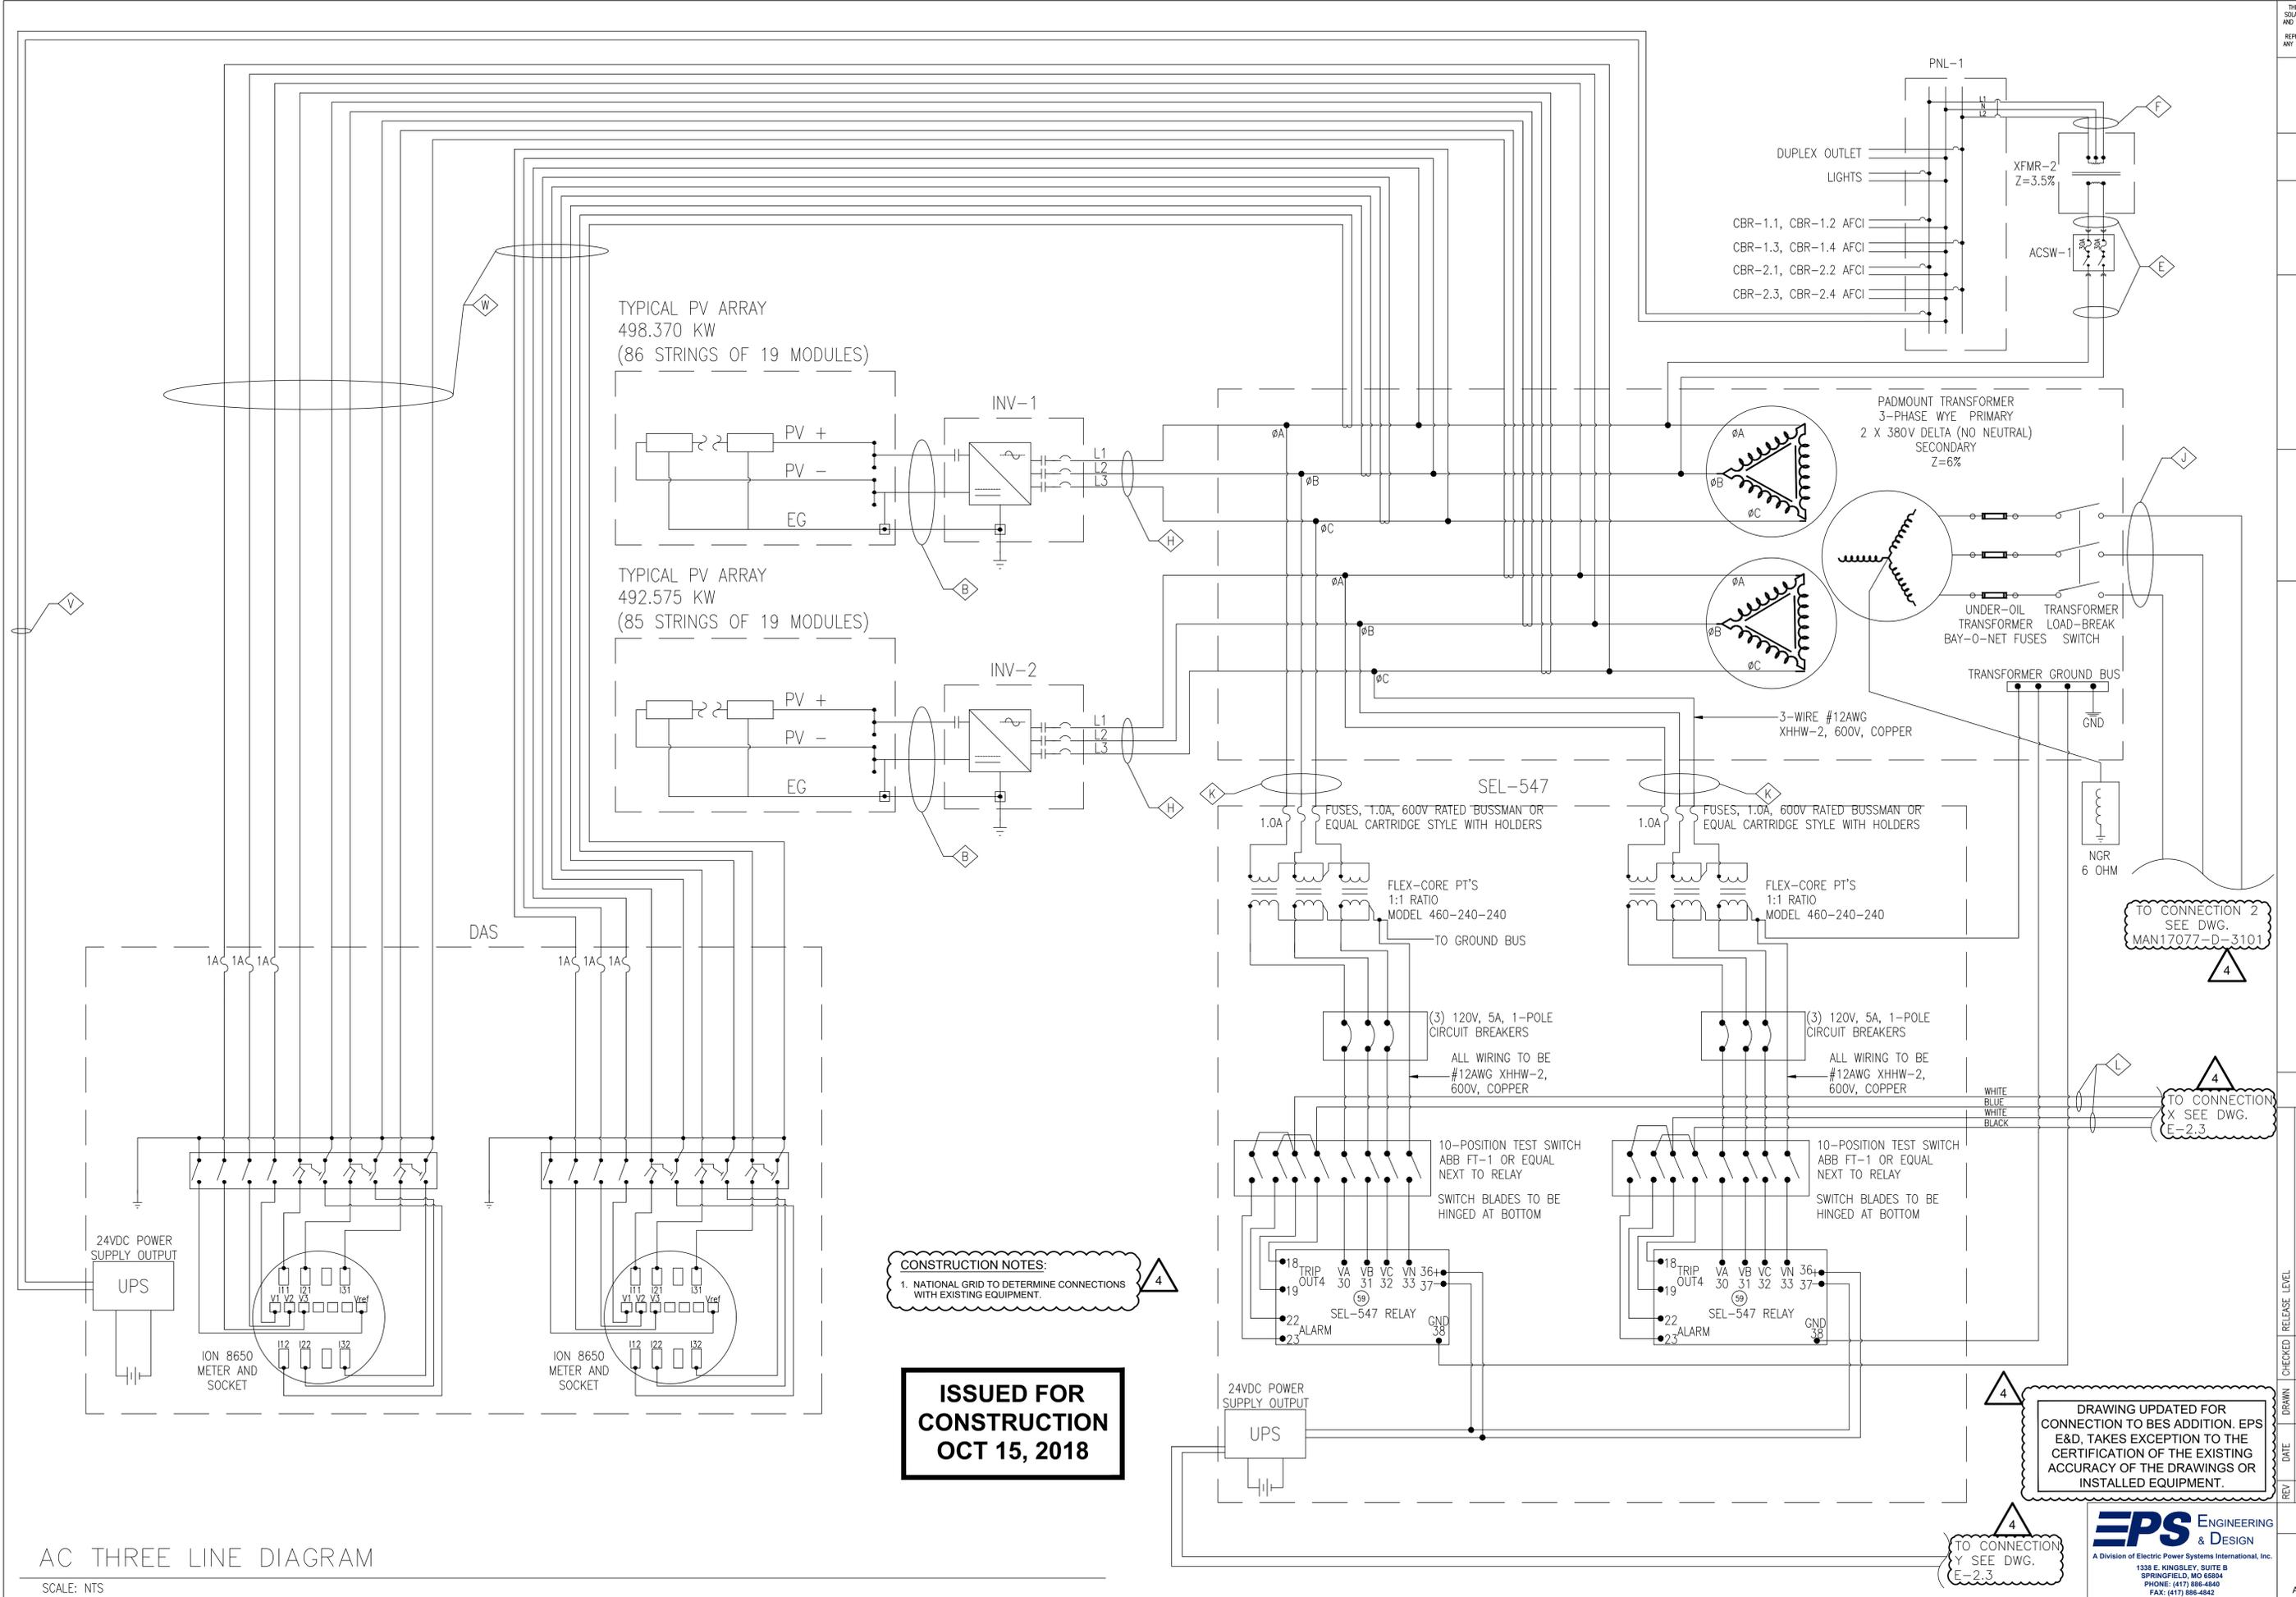

AC THREE LINE DIAGRAM

SCALE: NTS

**EPS ENGINEERING & DESIGN**  
A Division of Electric Power Systems International, Inc.  
1339 E. KINGSLEY, SUITE B  
SPRINGFIELD, MO 65804  
PHONE: (417) 886-4840  
FAX: (417) 886-4842